| ITEM | DESCRIPTION | QTY |
|---|---|---|
| | ROHACELL #51-IG 19mm THICK | |
| | | |
| | | |
| | | |
| | | |

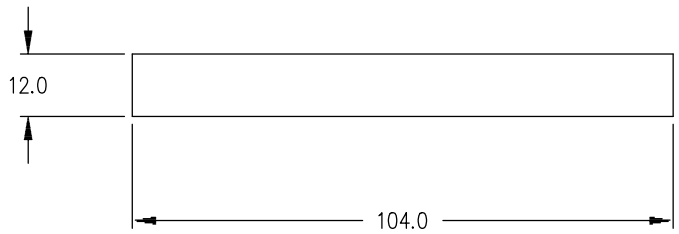


SUPPLIER INFORMATION:

NORTHERN FIBER GLASS SALES, INC.
102 TIDE MILL RD., P.O. BOX 2010
HAMPTON, NH 03843
PH: (603) 926-1910
FAX: (603) 926-1828

ALL DIMENSIONS ARE IN MILLIMETRES

| TOLERANCES UNLESS OTHERWISE SPECIFIED | |
|---|---|
| X.X | ± 0.5 mm |
| X.XX | ± 0.25 mm |
| ANGULAR DIMENSIONS | ± 0.25° |
| SURFACE FINISH 1.6 | OR BETTER (MICRONS) |

| REF. DWGS. | REV | REVISION DETAILS |
|---|---|---|
| PDE-0299D | A | DRAWING REFLECTS AS BUILT CONDITION. ISSUED: MAR 6 2000 M.L. |

UNIVERSITY OF VICTORIA
VICTORIA B.C. CANADA

DESIGNED P. BIRNEY
DRAWN M. LENCKOWSKI
CHECKED P. BIRNEY
APPROVED
TERRY HODGES
CHIEF ENGINEER

TRIUMF

# FOAM INSULATION BLOCK
## END CAP SIGNAL FEEDTHROUGH
## ATLAS END CAP CRYOSTAT

| SCALE 1 : 1 | SHT OF SHTS | DWG. NO. | REV |
|---|---|---|---|
| DATE MAR 00 | 1 1 | PDE-0303B | A |