ITEM	DESCRIPTION	QTY
	1/2 OZ 0.062" THICK PLATED THROUGH CIRCUIT BOARD	

COMPONENT SIDE

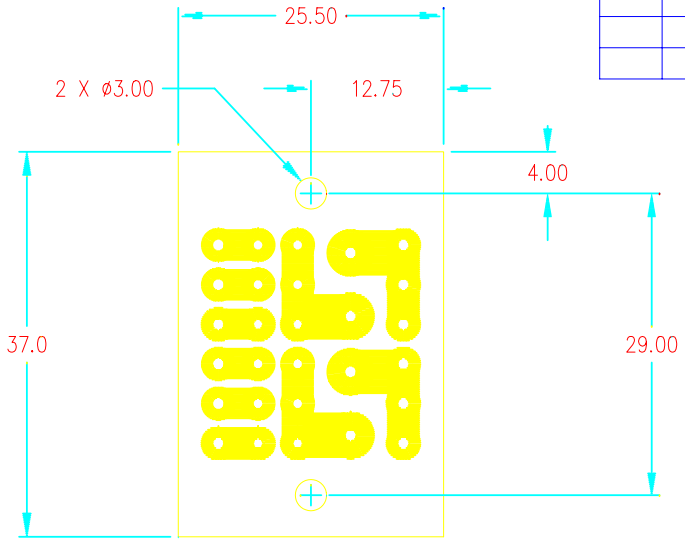

FOIL SIDE

ALL DIMENSIONS ARE IN MILLIMETRES

TOLERANCES UNLESS OTHERWISE SPECIFIED

X.X	± 0.5 mm
X.XX	± 0.25 mm
ANGULAR DIMENSIONS	± 0.25°
SURFACE FINISH 1.6	OR BETTER (MICRONS)

REF. DWGS.	REV	REVISION DETAILS
PDE-0305D	A	DRAWING REFLECTS AS BUILT CONDITION. ISSUED: OCT 6 2000 M.L.

UNIVERSITY OF VICTORIA
VICTORIA B.C. CANADA

DESIGNED U OF VIC
DRAWN M LENCKOWSKI
CHECKED R. LANGSTAFF
APPROVED
TERRY HODGES
CHIEF ENGINEER

TRIUMF

HEATER FUSE PCB

END CAP SIGNAL FEEDTHROUGH
ATLAS END CAP CRYOSTAT

SCALE 2 : 1	SHT 1 OF SHTS 1	DWG. NO. PDE-0306B	REV A
DATE OCT 00			